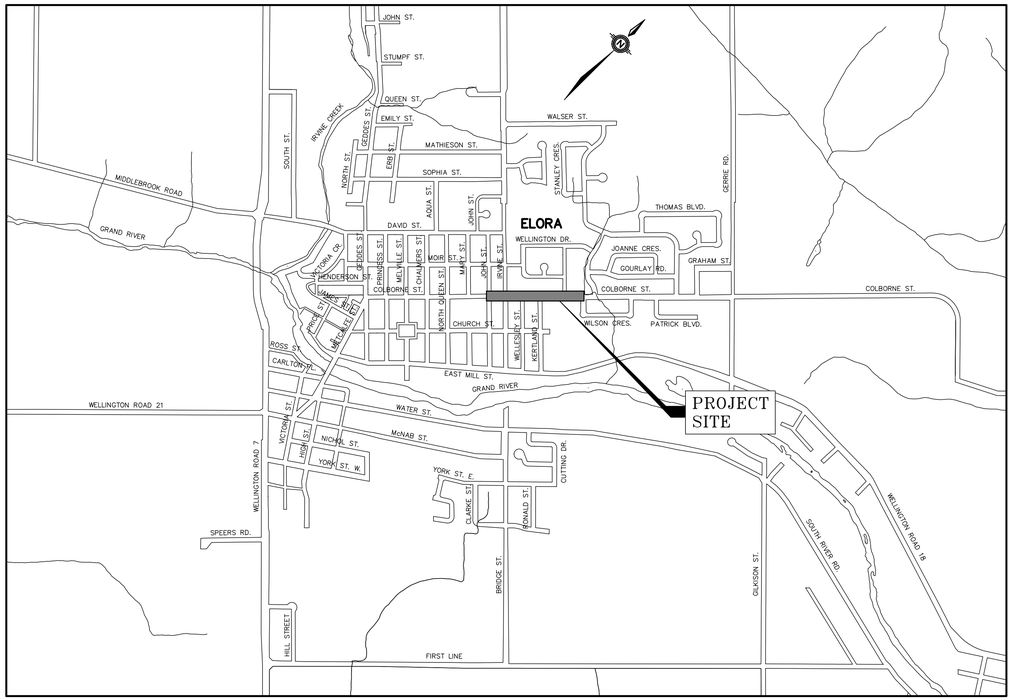


KEY PLAN – ELORA (CENTRE WELLINGTON)
N.T.S.

LIST OF DRAWINGS

01 – PLAN AND PROFILE
STA. 1+060 TO STA. 1+235

02 – PLAN AND PROFILE
STA. 1+235 TO STA. 1+410

03 – PLAN AND PROFILE
STA. 1+410 TO STA. 1+580

04 – TYPICAL SECTIONS & DETAILS

05 – GRADING PLAN
JOHN STREET TO CUTHBERT STREET

06 – GRADING PLAN
CUTHBERT STREET TO WILSON
CRESCENT

07 – PAVEMENT MARKING PLAN
JOHN STREET TO CUTHBERT STREET

08 – PAVEMENT MARKING PLAN
CUTHBERT STREET TO WILSON
CRESCENT AND STRUCTURE DATA CHART

Township of
Centre Wellington

Centre Wellington

RECONSTRUCTION OF
COLBORNE STREET
(ELORA)


PROJECT No. M6488
CONTRACT No. RFT-33-25

Mayor:
SHAWN WATTERS

Chief Administrative Officer:
DAN WILSON

ISSUED FOR TENDER – MARCH 2025
ISSUED FOR CONSTRUCTION – MAY 2025
AS RECORDED –

TRITON ENGINEERING SERVICES LIMITED
Consulting Engineers
Fergus, Ontario

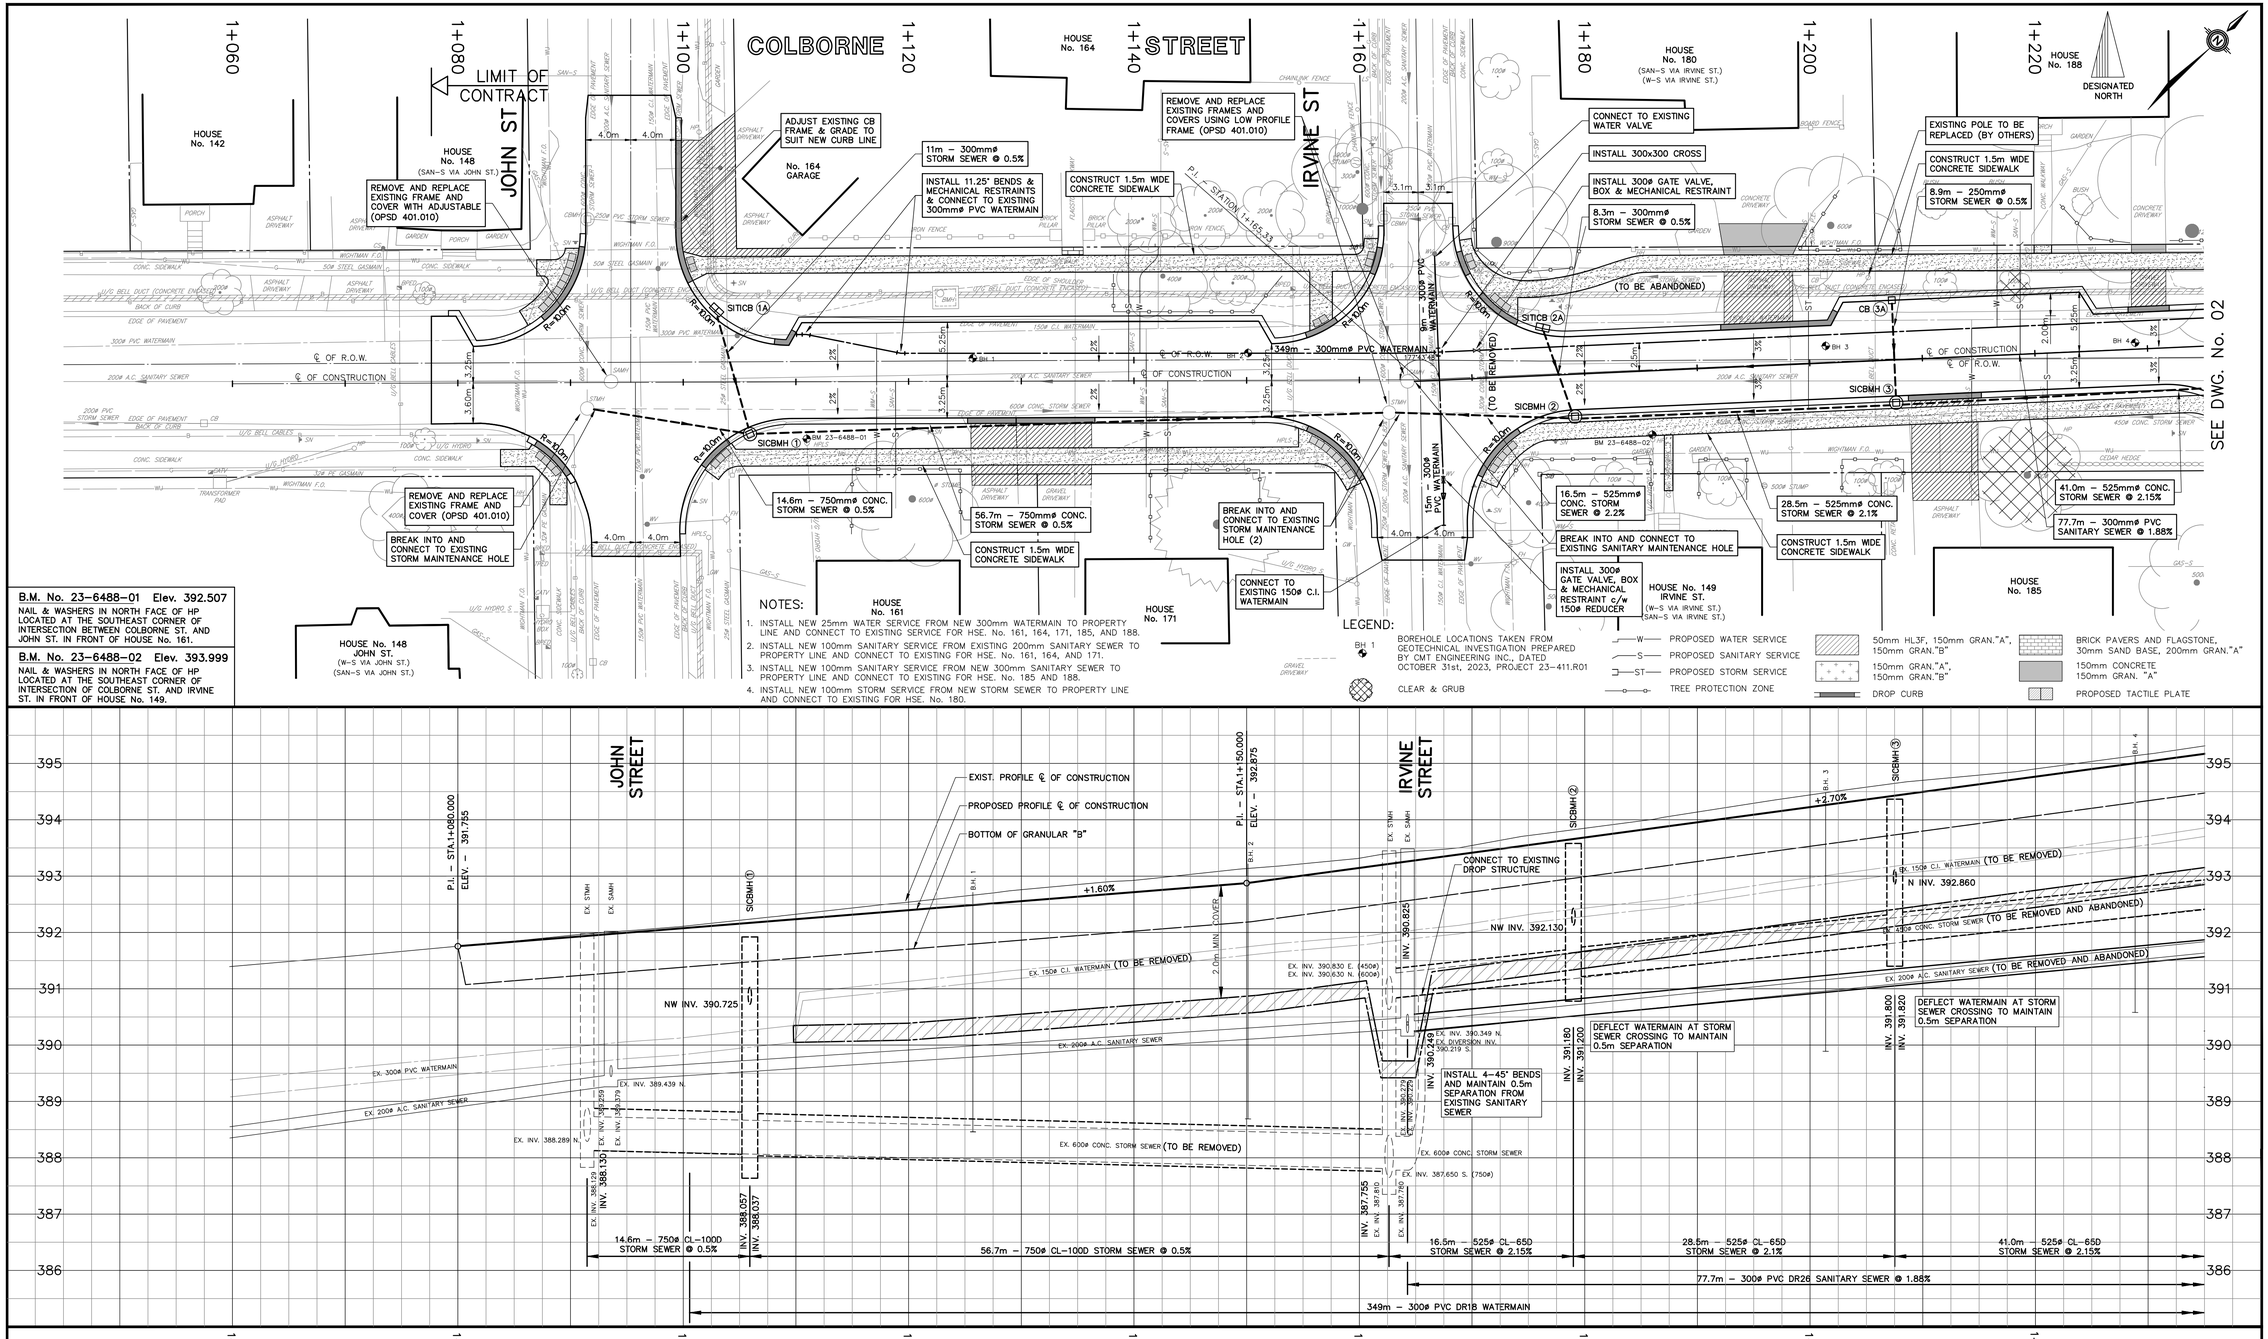

PRELIMINARY

PRELIMINARY

DISCLAIMERS:
1. ALL EXISTING ELEVATIONS & DIMENSIONS TO BE CONFIRMED ON SITE. THE LOCATION OF UTILITIES IS APPROXIMATE ONLY AND SHOULD BE, DETERMINED BY CONSULTING THE MUNICIPAL AUTHORITIES AND UTILITY COMPANIES CONCERNED. THE CONTRACTOR SHALL PROVE THE LOCATION OF UTILITIES AND SHALL BE RESPONSIBLE FOR ADEQUATE PROTECTION AGAINST DAMAGE.

No	DATE	REVISION	INITIAL
2	MAY 2025	ISSUED FOR CONSTRUCTION	D.G.D.
1	MAR 2025	ISSUED FOR TENDER	D.G.D.

PRELIMINARY

RECONSTRUCTION OF
COLBORNE STREET
(ELORA)

TOWNSHIP OF CENTRE WELLINGTON
1 MACDONALD SQUARE
ELORA, ONTARIO N0B 1S0

PLAN AND PROFILE
1+060 TO 1+235

CONTRACT No.	RFT-33-25
PROJECT No.	M6488
DRAWN BY:	A.V.R.
CHECKED BY:	D.P.S.
APPROVED BY:	D.G.D.
DATE:	JANUARY 2024


TRITON ENGINEERING SERVICES LIMITED
Consulting Engineers

SCALE:
H: 1:250 H: 1:500
V: 1:50 V: 1:100
(24"x36") (11"x17")
UNLESS OTHERWISE SHOWN

DRAWING NUMBER 01

I:\Centre wellington\m6488 – colborne st (john-wilson), elora\civil and survey\m6488 – colborne st c36.dwg – 2024-09-23 – ovonoyen

ARCH full bleed D (36.00 x 24.00 Inches)

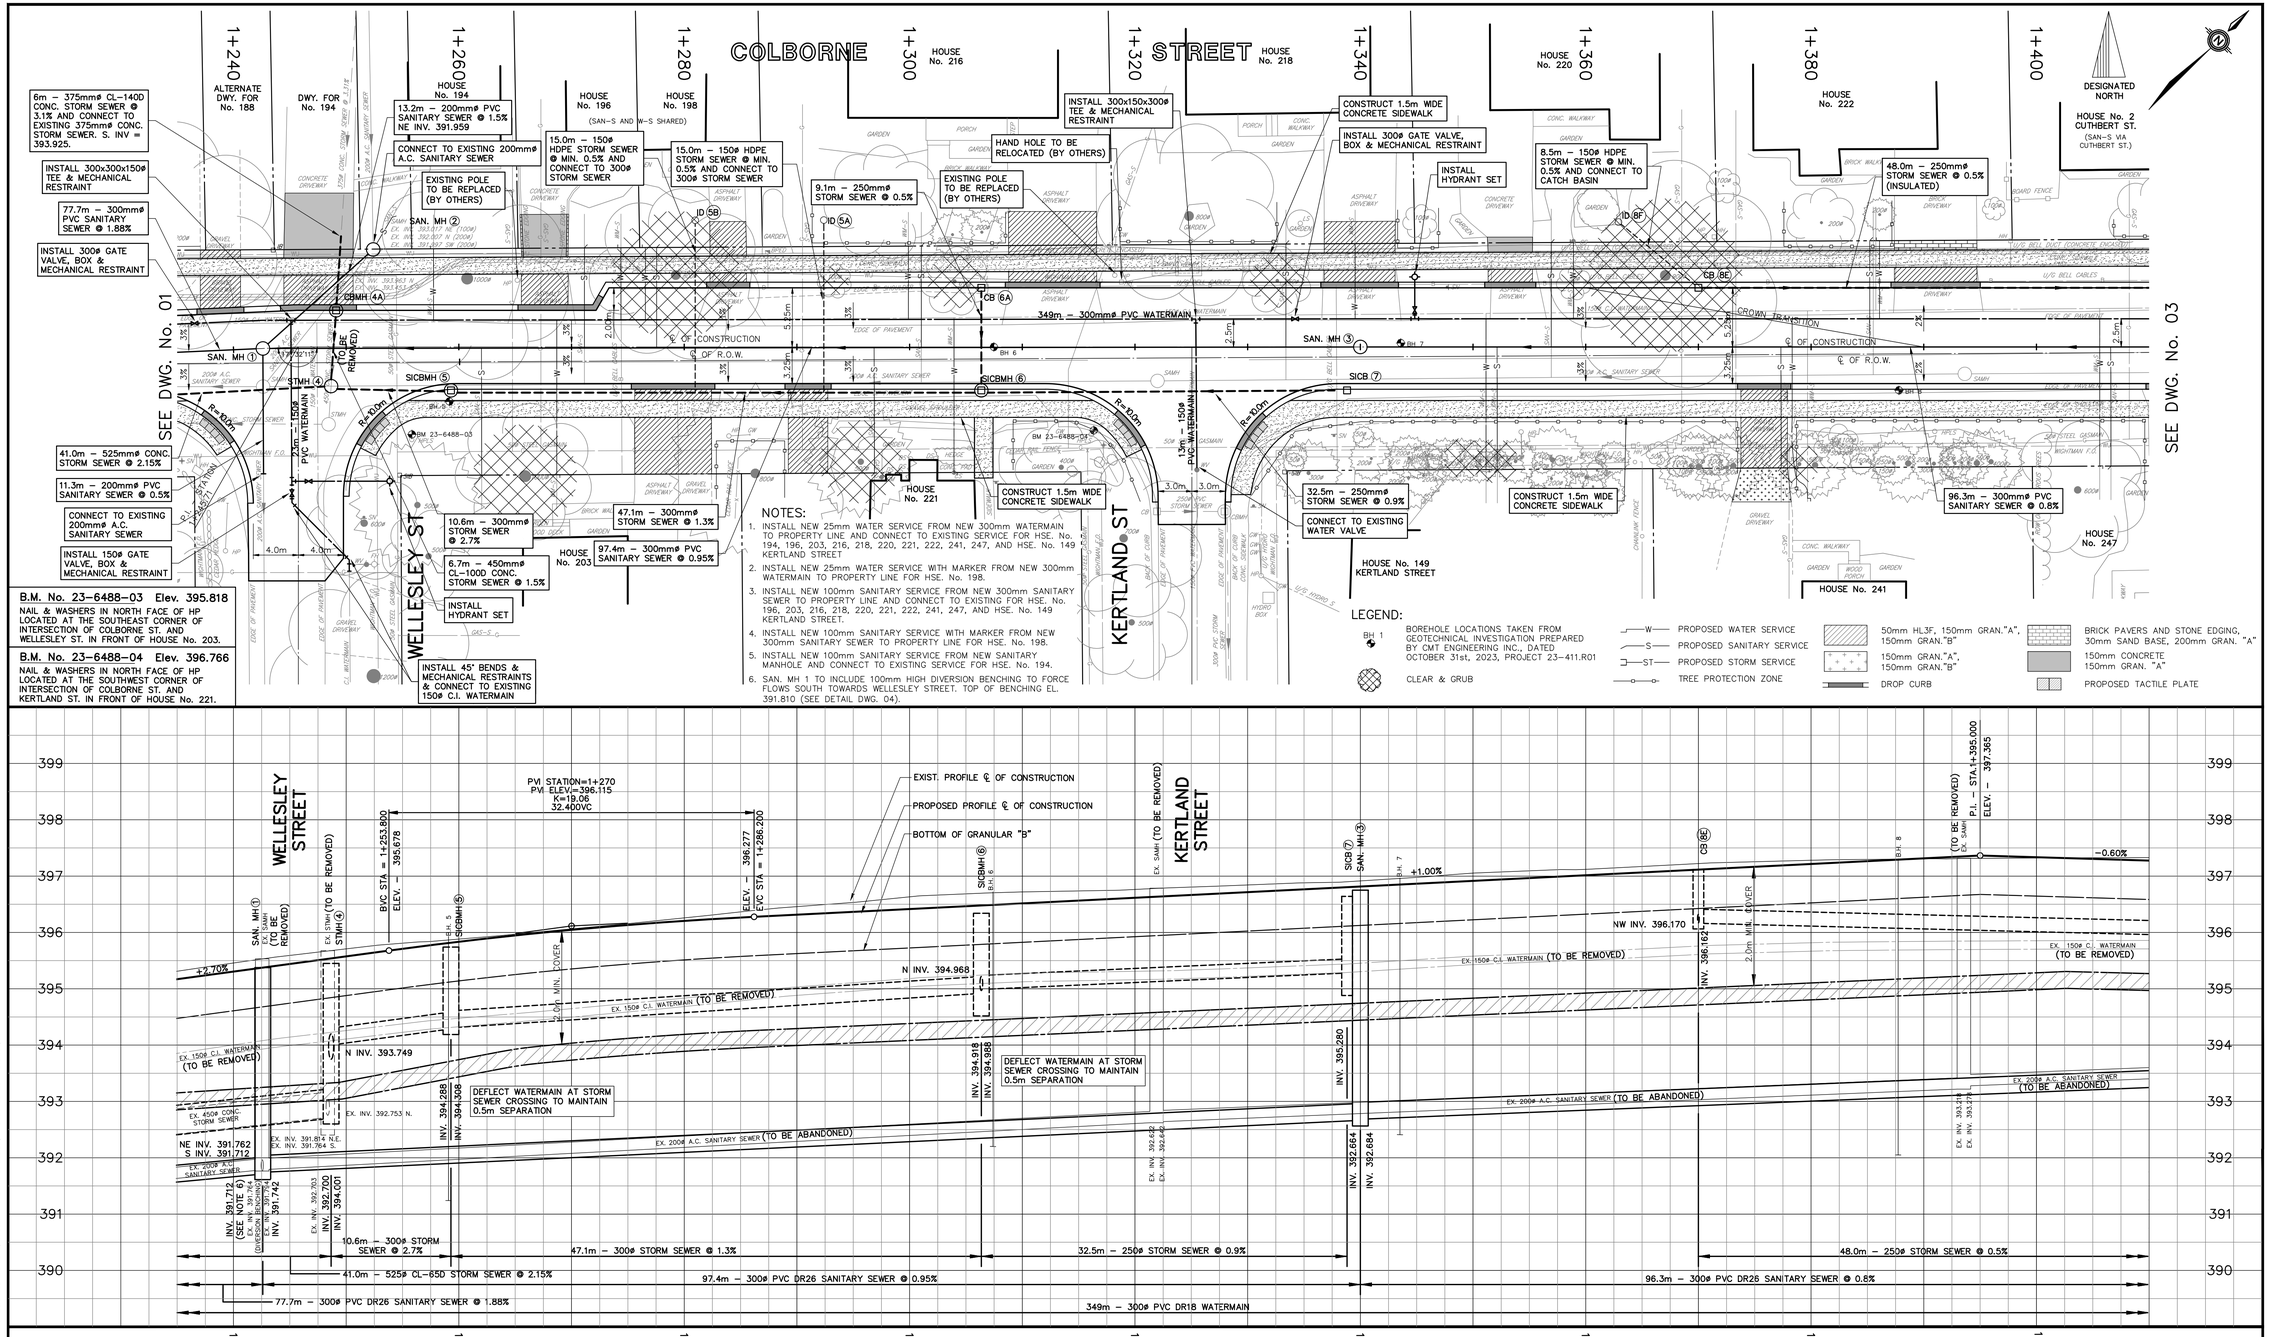

PRELIMINARY

PRELIMINARY

DISCLAIMERS:
1. ALL EXISTING ELEVATIONS & DIMENSIONS TO BE CONFIRMED ON SITE. THE LOCATION OF UTILITIES IS APPROXIMATE ONLY AND SHOULD BE, DETERMINED BY CONSULTING THE MUNICIPAL AUTHORITIES AND UTILITY COMPANIES CONCERNED. THE CONTRACTOR SHALL PROVE THE LOCATION OF UTILITIES AND SHALL BE RESPONSIBLE FOR ADEQUATE PROTECTION AGAINST DAMAGE.

No	DATE	REVISION	INITIAL
2	MAY 2025	ISSUED FOR CONSTRUCTION	D.G.D.
1	MAR 2025	ISSUED FOR TENDER	D.G.D.

PRELIMINARY

RECONSTRUCTION OF
COLBORNE STREET
(ELORA)

TOWNSHIP OF CENTRE WELLINGTON
1 MACDONALD SQUARE
ELORA, ONTARIO N0B 1S0

PLAN AND PROFILE
1+235 TO 1+410

CONTRACT No.	RFT–33–25
PROJECT No.	M6488
DRAWN BY:	A.V.R.
CHECKED BY:	D.P.S.
APPROVED BY:	D.G.D.
DATE:	JANUARY 2024


TRITON ENGINEERING SERVICES LIMITED
Consulting Engineers

SCALE:
H: 1:250 H: 1:500
V: 1:50 V: 1:100
(24"x36") (11"x17")
UNLESS OTHERWISE SHOWN

DRAWING NUMBER 02

I:\centre wellington\m6488 – colborne st (john-wilson), elora\civil and survey\m6488 – colborne st c3d.dwg – 2024-09-23 – onnonoyen

ARCH full bleed D (36.00 x 24.00 Inches)

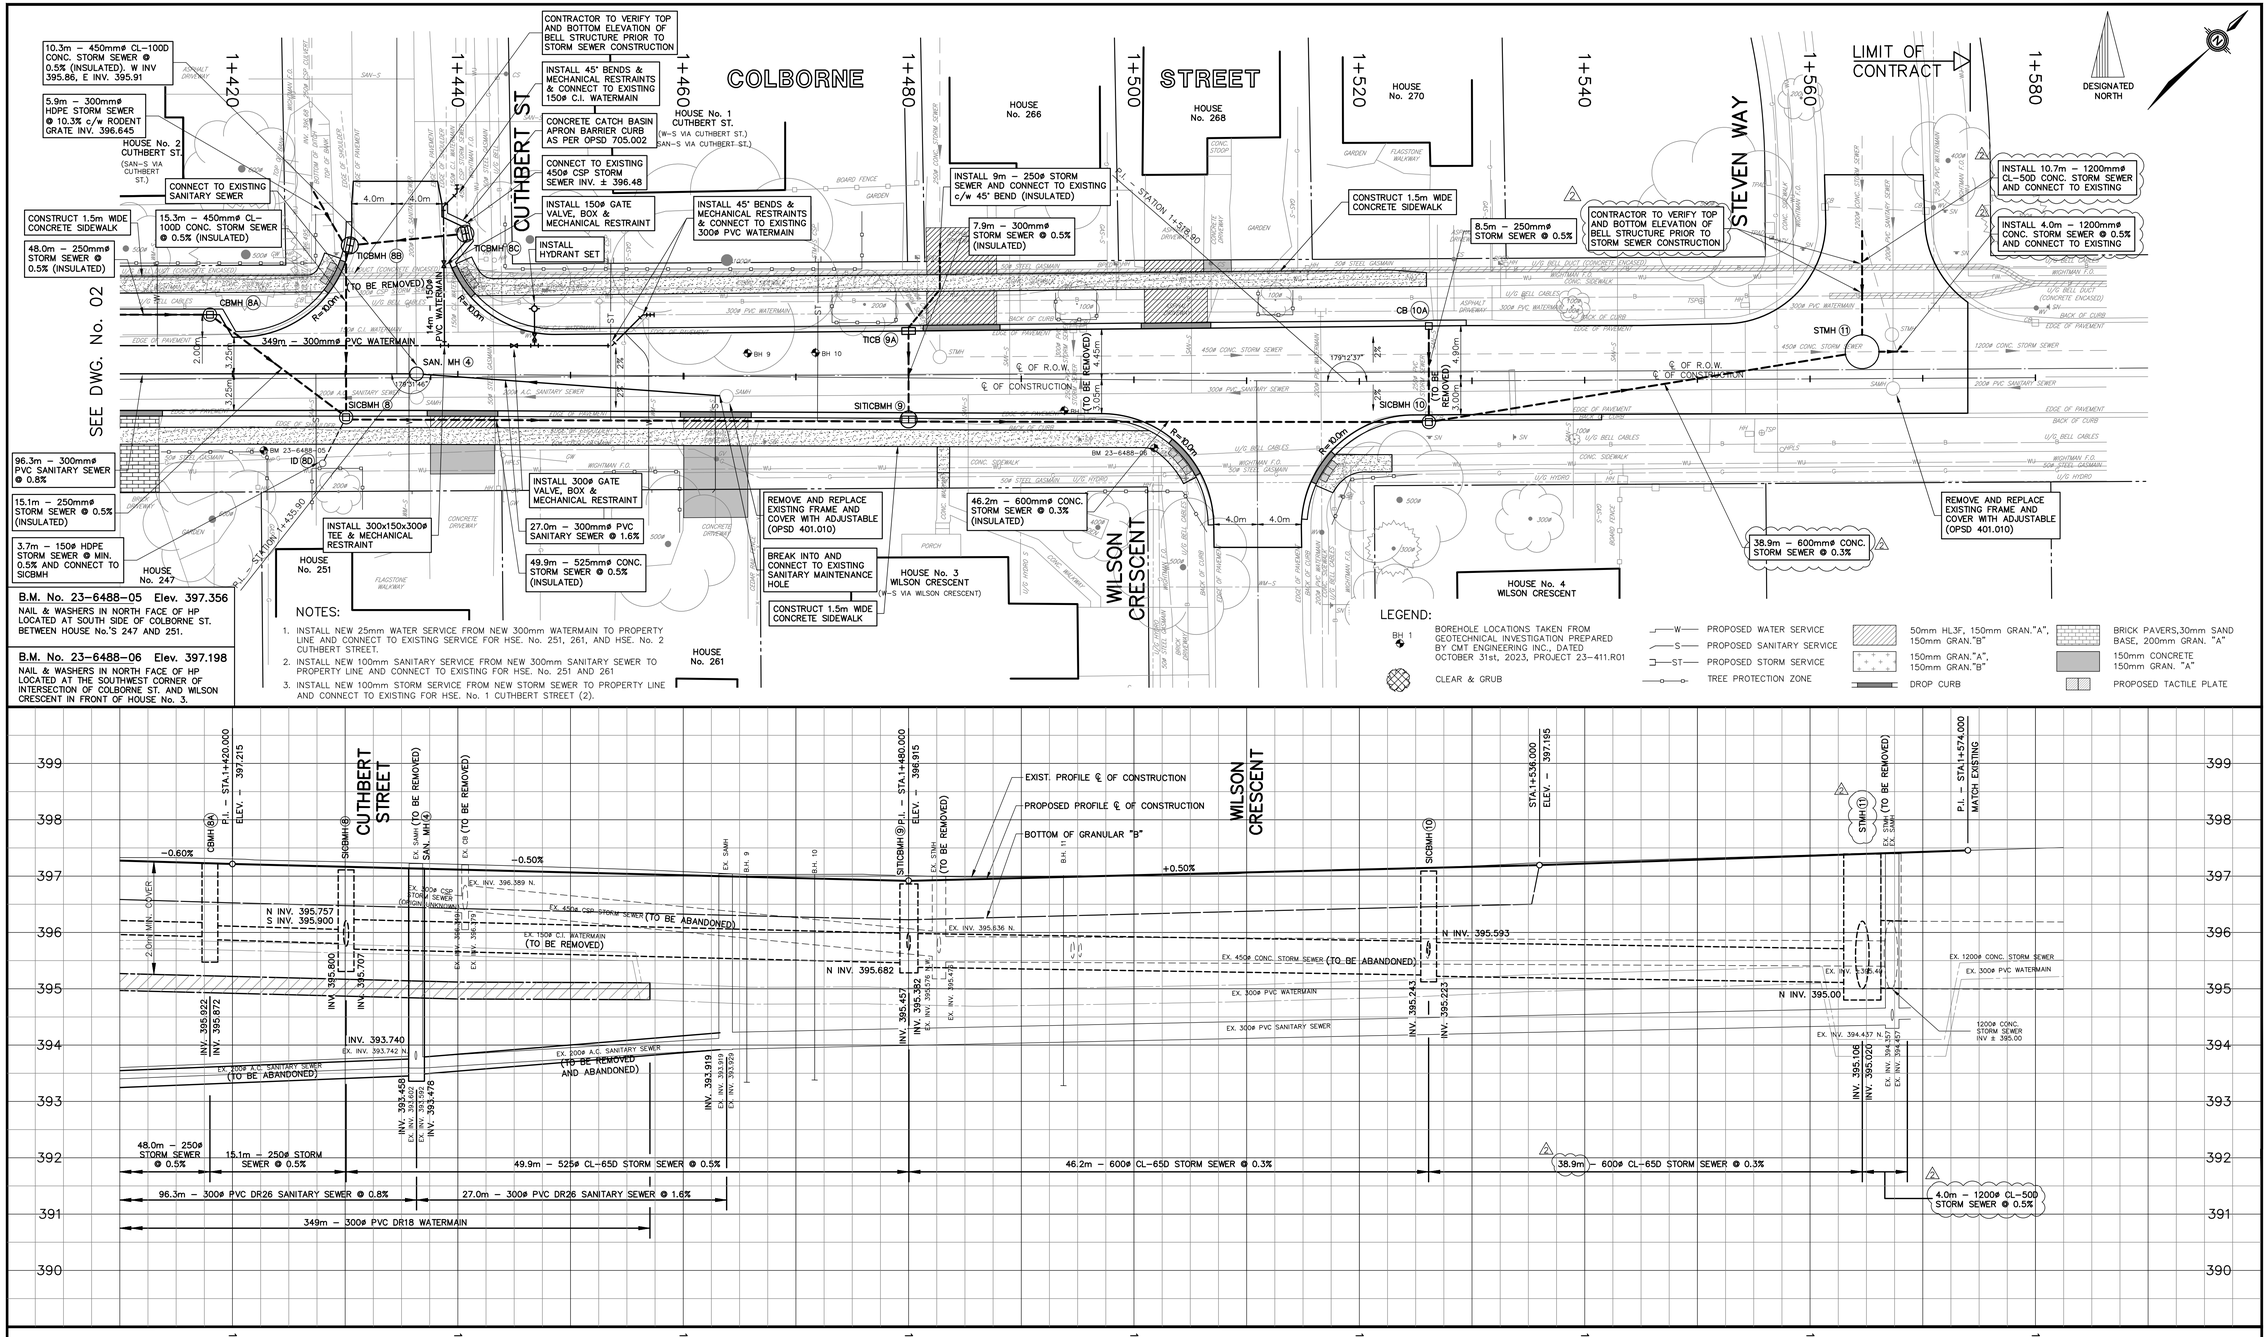

PRELIMINARY

PRELIMINARY

DISCLAIMERS:
1. ALL EXISTING ELEVATIONS & DIMENSIONS TO BE CONFIRMED ON SITE. THE LOCATION OF UTILITIES IS APPROXIMATE ONLY AND SHOULD BE, DETERMINED BY CONSULTING THE MUNICIPAL AUTHORITIES AND UTILITY COMPANIES CONCERNED. THE CONTRACTOR SHALL PROVE THE LOCATION OF UTILITIES AND SHALL BE RESPONSIBLE FOR ADEQUATE PROTECTION AGAINST DAMAGE.

No	DATE	REVISION	INITIAL
3	MAY 2025	ISSUED FOR CONSTRUCTION	D.G.D.
2	MAY 2025	REVISED STORM SEWER	D.G.D.
1	MAR 2025	ISSUED FOR TENDER	D.G.D.

PRELIMINARY

RECONSTRUCTION OF
COLBORNE STREET
(ELORA)

TOWNSHIP OF CENTRE WELLINGTON
1 MACDONALD SQUARE
ELORA, ONTARIO N0B 1S0

PLAN AND PROFILE
1+410 TO 1+580

CONTRACT No.	RFT–33–25
PROJECT No.	M6488
DRAWN BY:	A.V.R.
CHECKED BY:	D.P.S.
APPROVED BY:	D.G.D.
DATE:	JANUARY 2024


TRITON ENGINEERING SERVICES LIMITED
Consulting Engineers

SCALE:
H: 1:250 V: 1:50 (24"x36")
H: 1:500 V: 1:100 (11"x17")
UNLESS OTHERWISE SHOWN


DRAWING NUMBER 03

I:\centre wellington\m6488 – colborne st (john–wilson), elora\civil and survey\m6488 – colborne st c36.dwg – 2024–09–23 – avanroyen


ARCH full bleed D (36.00 x 24.00 Inches)

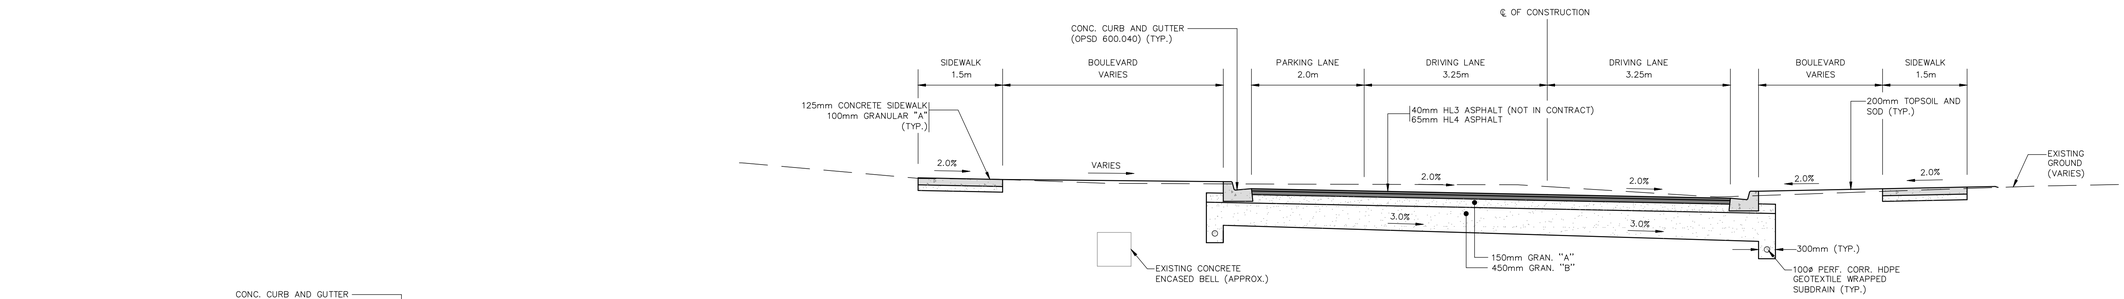


TYPICAL ROAD SECTION – COLBORNE STREET
STA. 1+110 TO STA. 1+180

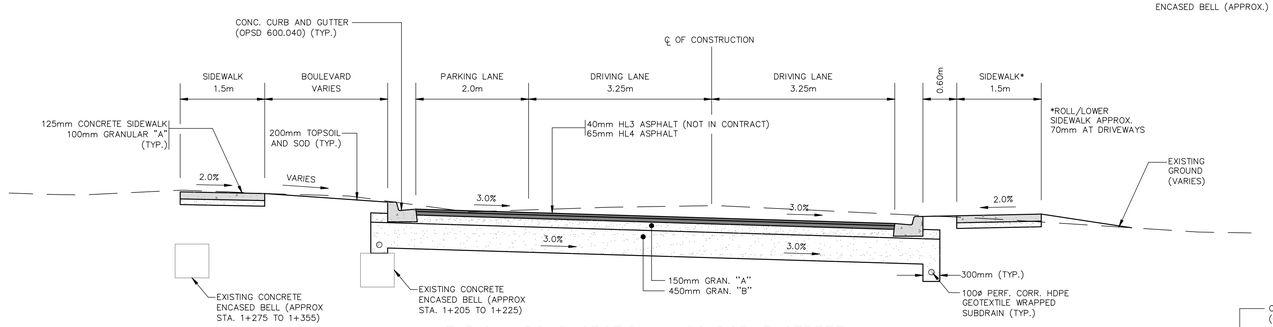


TYPICAL ROAD SECTION – COLBORNE STREET
STA. 1+205 TO STA. 1+225 & STA. 1+275 TO STA. 1+355

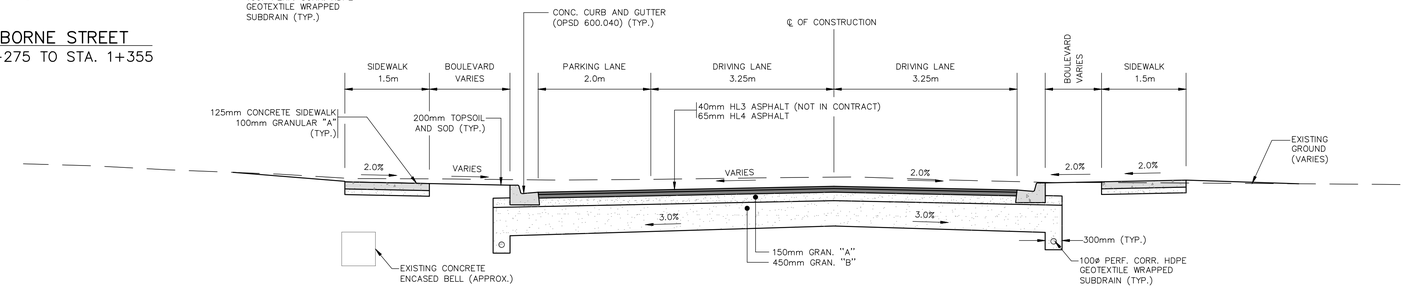

TYPICAL ROAD SECTION – COLBORNE STREET
STA. 1+395 TO STA. 1+420

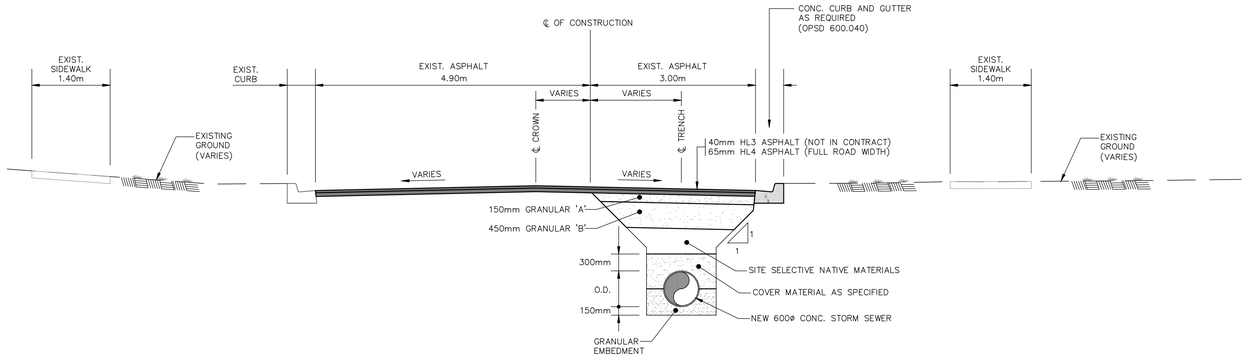

TYPICAL ROAD SECTION – COLBORNE STREET
STA. 1+530 TO STA. 1+574

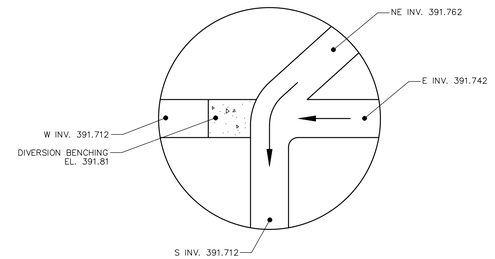

SAN. MH 1 – DIVERSION BENCHING DETAIL
N.T.S.

PRELIMINARY

PRELIMINARY

DISCLAIMERS:
1. ALL EXISTING ELEVATIONS & DIMENSIONS TO BE CONFIRMED ON SITE. THE LOCATION OF UTILITIES IS APPROXIMATE ONLY AND SHOULD BE, DETERMINED BY CONSULTING THE MUNICIPAL AUTHORITIES AND UTILITY COMPANIES CONCERNED. THE CONTRACTOR SHALL PROVE THE LOCATION OF UTILITIES AND SHALL BE RESPONSIBLE FOR ADEQUATE PROTECTION AGAINST DAMAGE.

No	DATE	REVISION	INITIAL
2	MAY 2025	ISSUED FOR CONSTRUCTION	D.G.D.
1	MAR 2025	ISSUED FOR TENDER	D.G.D.

PRELIMINARY

RECONSTRUCTION OF
COLBORNE STREET
(ELORA)

TOWNSHIP OF CENTRE WELLINGTON
1 MACDONALD SQUARE
ELORA, ONTARIO N0B 1S0

TYPICAL SECTIONS & DETAILS

CONTRACT No.	RFT-33-25
PROJECT No.	M6488
DRAWN BY:	A.V.R.
CHECKED BY:	D.P.S.
APPROVED BY:	D.G.D.
DATE:	NOVEMBER 2024


TRITON ENGINEERING SERVICES LIMITED
Consulting Engineers


SCALE:
NTS (24"x36") NTS (11"x17")
UNLESS OTHERWISE SHOWN

DRAWING NUMBER 04

r:\centre wellington\m6488 – colborne st (john–wilson), elora\civil and survey\m6488 – colborne st c3d.dwg – 2024-09-23 – ovonnoyen

ARCH full bleed D (36.00 x 24.00 Inches)

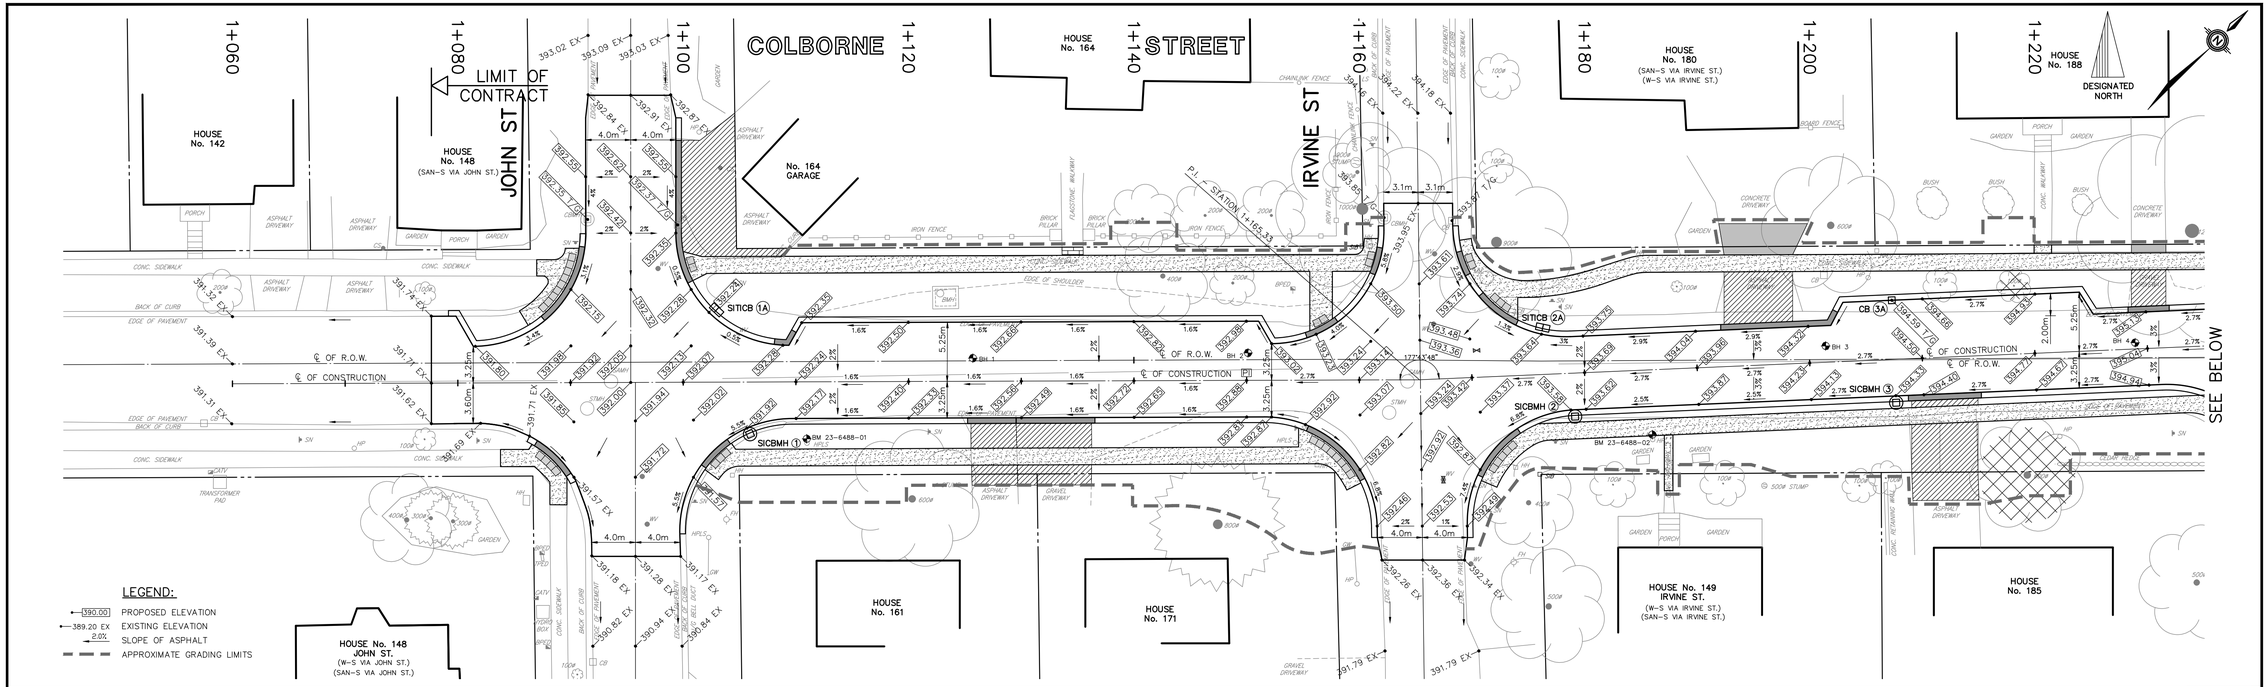

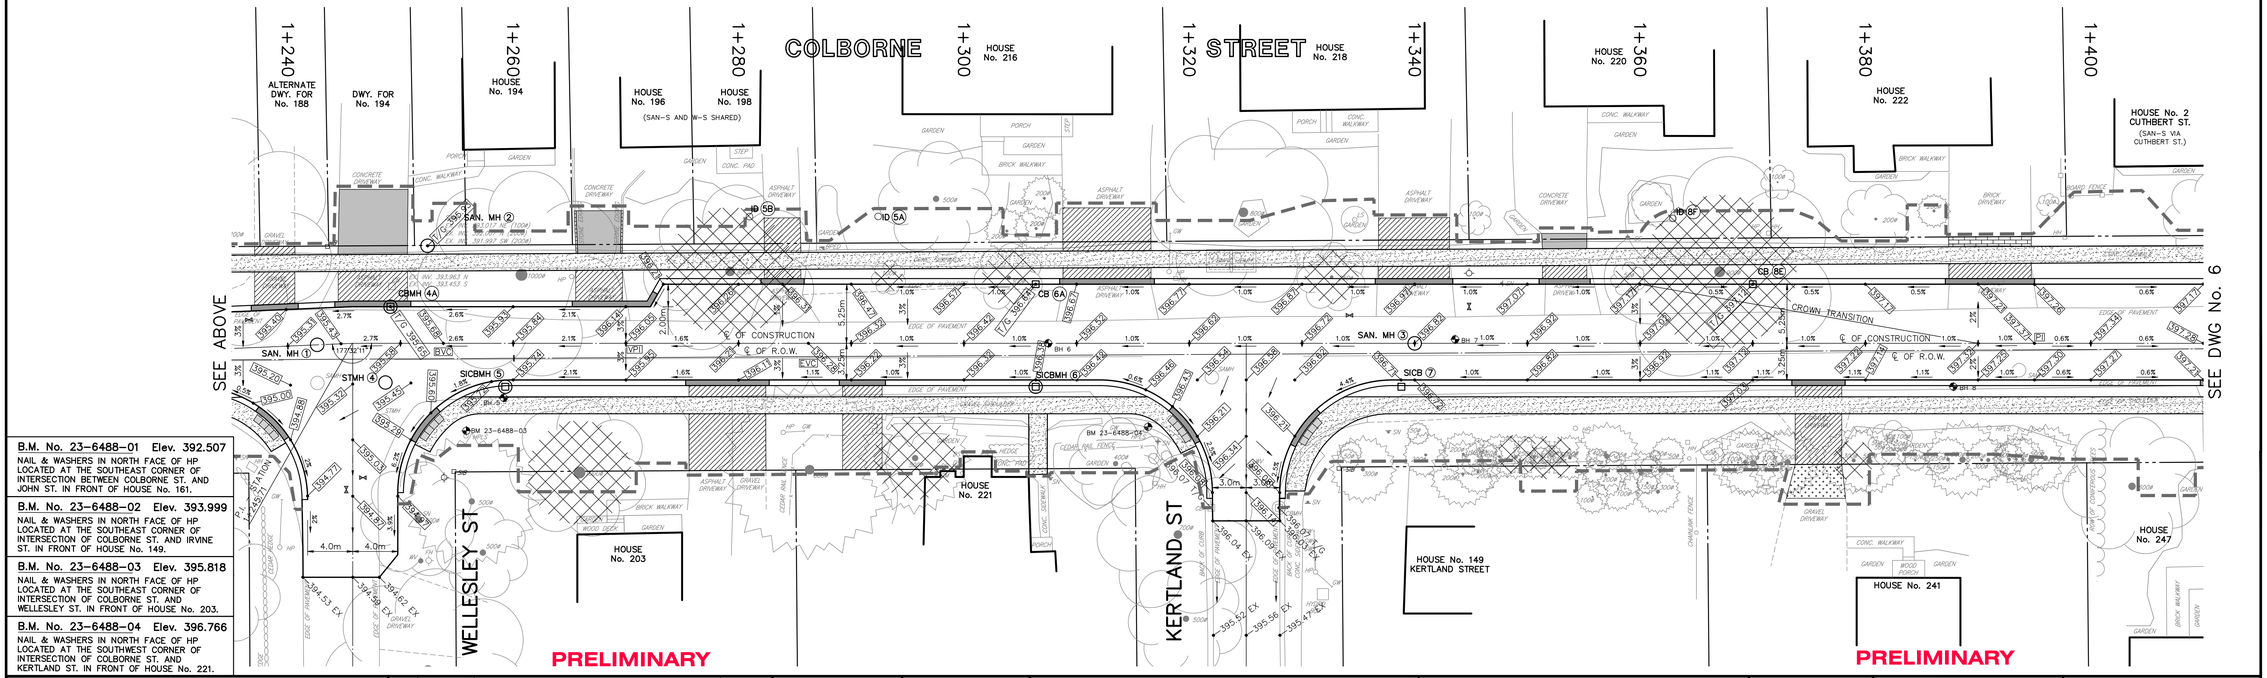

B.M. No. 23–6488–01 Elev. 392.507
NAIL & WASHERS IN NORTH FACE OF HP LOCATED AT THE SOUTHEAST CORNER OF INTERSECTION BETWEEN COLBORNE ST. AND JOHN ST. IN FRONT OF HOUSE No. 161.

B.M. No. 23–6488–02 Elev. 393.999
NAIL & WASHERS IN NORTH FACE OF HP LOCATED AT THE SOUTHEAST CORNER OF INTERSECTION OF COLBORNE ST. AND IRVINE ST. IN FRONT OF HOUSE No. 149.

B.M. No. 23–6488–03 Elev. 395.818
NAIL & WASHERS IN NORTH FACE OF HP LOCATED AT THE SOUTHEAST CORNER OF INTERSECTION OF COLBORNE ST. AND WELLESLEY ST. IN FRONT OF HOUSE No. 203.

B.M. No. 23–6488–04 Elev. 396.766
NAIL & WASHERS IN NORTH FACE OF HP LOCATED AT THE SOUTHWEST CORNER OF INTERSECTION OF COLBORNE ST. AND KERTLAND ST. IN FRONT OF HOUSE No. 221.

DISCLAIMERS:
1. ALL EXISTING ELEVATIONS & DIMENSIONS TO BE CONFIRMED ON SITE. THE LOCATION OF UTILITIES IS APPROXIMATE ONLY AND SHOULD BE, DETERMINED BY CONSULTING THE MUNICIPAL AUTHORITIES AND UTILITY COMPANIES CONCERNED. THE CONTRACTOR SHALL PROVE THE LOCATION OF UTILITIES AND SHALL BE RESPONSIBLE FOR ADEQUATE PROTECTION AGAINST DAMAGE.

No	DATE	REVISION	INITIAL
2	MAY 2025	ISSUED FOR CONSTRUCTION	D.G.D.
1	MAR 2025	ISSUED FOR TENDER	D.G.D.

PRELIMINARY

RECONSTRUCTION OF
COLBORNE STREET
(ELORA)

TOWNSHIP OF CENTRE WELLINGTON
1 MACDONALD SQUARE
ELORA, ONTARIO N0B 1S0

GRADING PLAN
1+050 TO 1+410

CONTRACT No.	RFT–33–25
PROJECT No.	M6488
DRAWN BY:	A.V.R.
CHECKED BY:	D.P.S.
APPROVED BY:	D.G.D.
DATE:	SEPTEMBER 2024


TRITON ENGINEERING SERVICES LIMITED
Consulting Engineers

SCALE:
H: 1:250 H: 1:500
V: 1:50 V: 1:100
(24"x36") (11"x17")
UNLESS OTHERWISE SHOWN

DRAWING NUMBER **05**

I:\Centre wellington\m6488 – colborne st (john–wilson), elora\civil and survey\m6488 – colborne st c36.dwg – 2024–09–23 – onnonoyen

ARCH full bleed D (36.00 x 24.00 Inches)

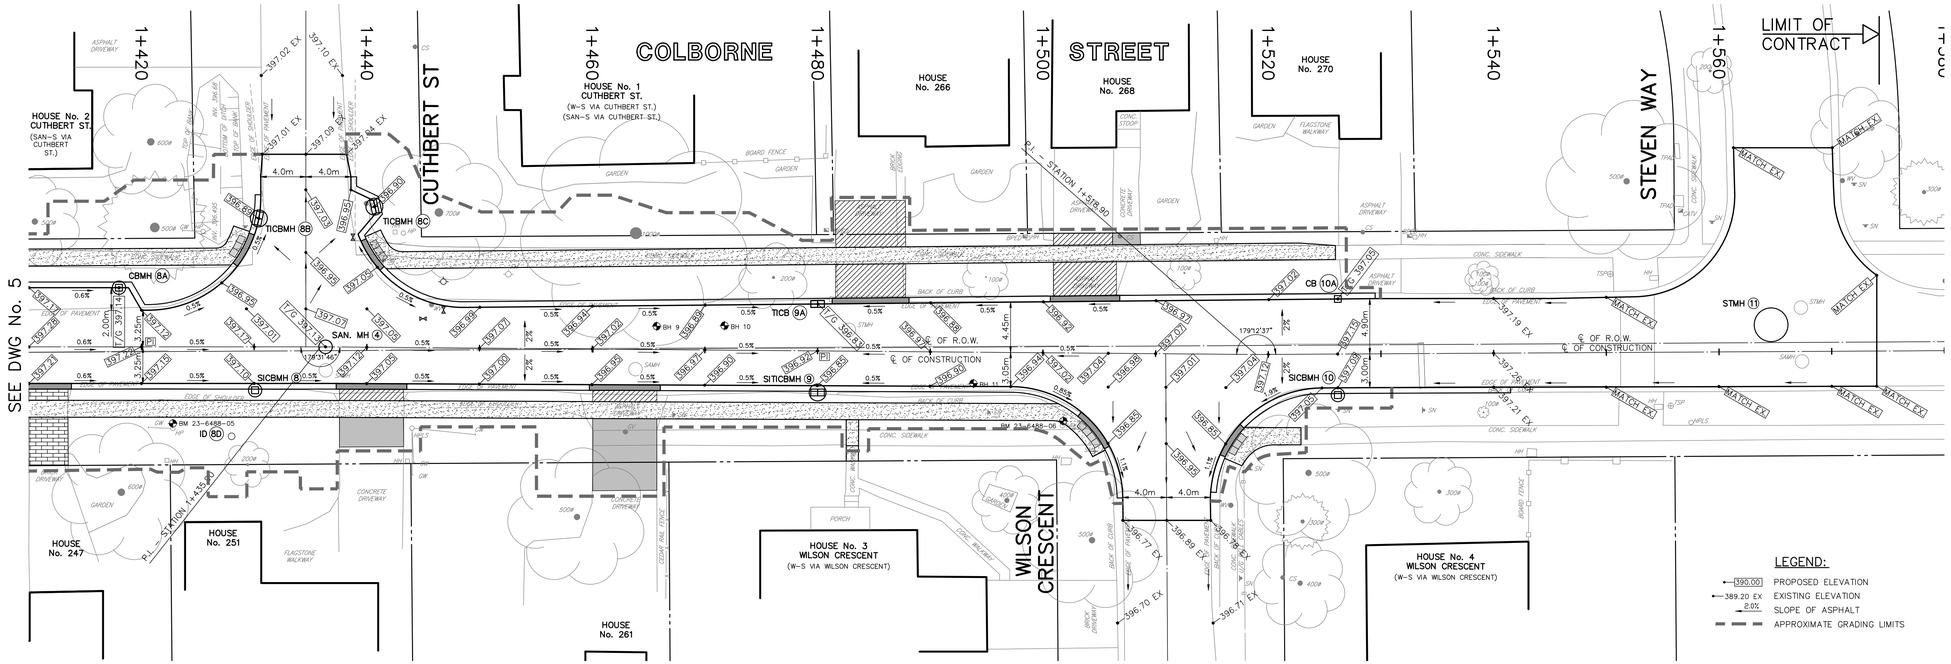

B.M. No. 23–6488–05 Elev. 397.356
NAIL & WASHERS IN NORTH FACE OF HP LOCATED AT SOUTH SIDE OF COLBORNE ST. BETWEEN HOUSE No.'S 247 AND 251.

B.M. No. 23–6488–06 Elev. 397.198
NAIL & WASHERS IN NORTH FACE OF HP LOCATED AT THE SOUTHWEST CORNER OF INTERSECTION OF COLBORNE ST. AND WILSON CRESCENT IN FRONT OF HOUSE No. 3.

PRELIMINARY

DISCLAIMERS:
1. ALL EXISTING ELEVATIONS & DIMENSIONS TO BE CONFIRMED ON SITE. THE LOCATION OF UTILITIES IS APPROXIMATE ONLY AND SHOULD BE, DETERMINED BY CONSULTING THE MUNICIPAL AUTHORITIES AND UTILITY COMPANIES CONCERNED. THE CONTRACTOR SHALL PROVE THE LOCATION OF UTILITIES AND SHALL BE RESPONSIBLE FOR ADEQUATE PROTECTION AGAINST DAMAGE.

No	DATE	REVISION	INITIAL
2	MAY 2025	ISSUED FOR CONSTRUCTION	D.G.D.
1	MAR 2025	ISSUED FOR TENDER	D.G.D.

PRELIMINARY

RECONSTRUCTION OF
COLBORNE STREET
(ELORA)

TOWNSHIP OF CENTRE WELLINGTON
1 MACDONALD SQUARE
ELORA, ONTARIO N0B 1S0

GRADING PLAN
1+410 TO 1+580

PRELIMINARY

CONTRACT No.	RFT–33–25
PROJECT No.	M6488
DRAWN BY:	A.V.R.
CHECKED BY:	D.P.S.
APPROVED BY:	D.G.D.
DATE:	OCTOBER 2024


TRITON ENGINEERING SERVICES LIMITED
Consulting Engineers


SCALE:
H: 1: 250 H: 1: 500
V: 1: 50 V: 1: 100
(24x36") (11x17")
UNLESS OTHERWISE SHOWN

DRAWING NUMBER **06**

r:\centre wellington\m6488 – colborne st (john–wilson), elora\cad and survey\m6488 – colborne st c3d.dwg – 2024–09–23 – avanmooyen

ARCH full bleed D (36.00 x 24.00 Inches)

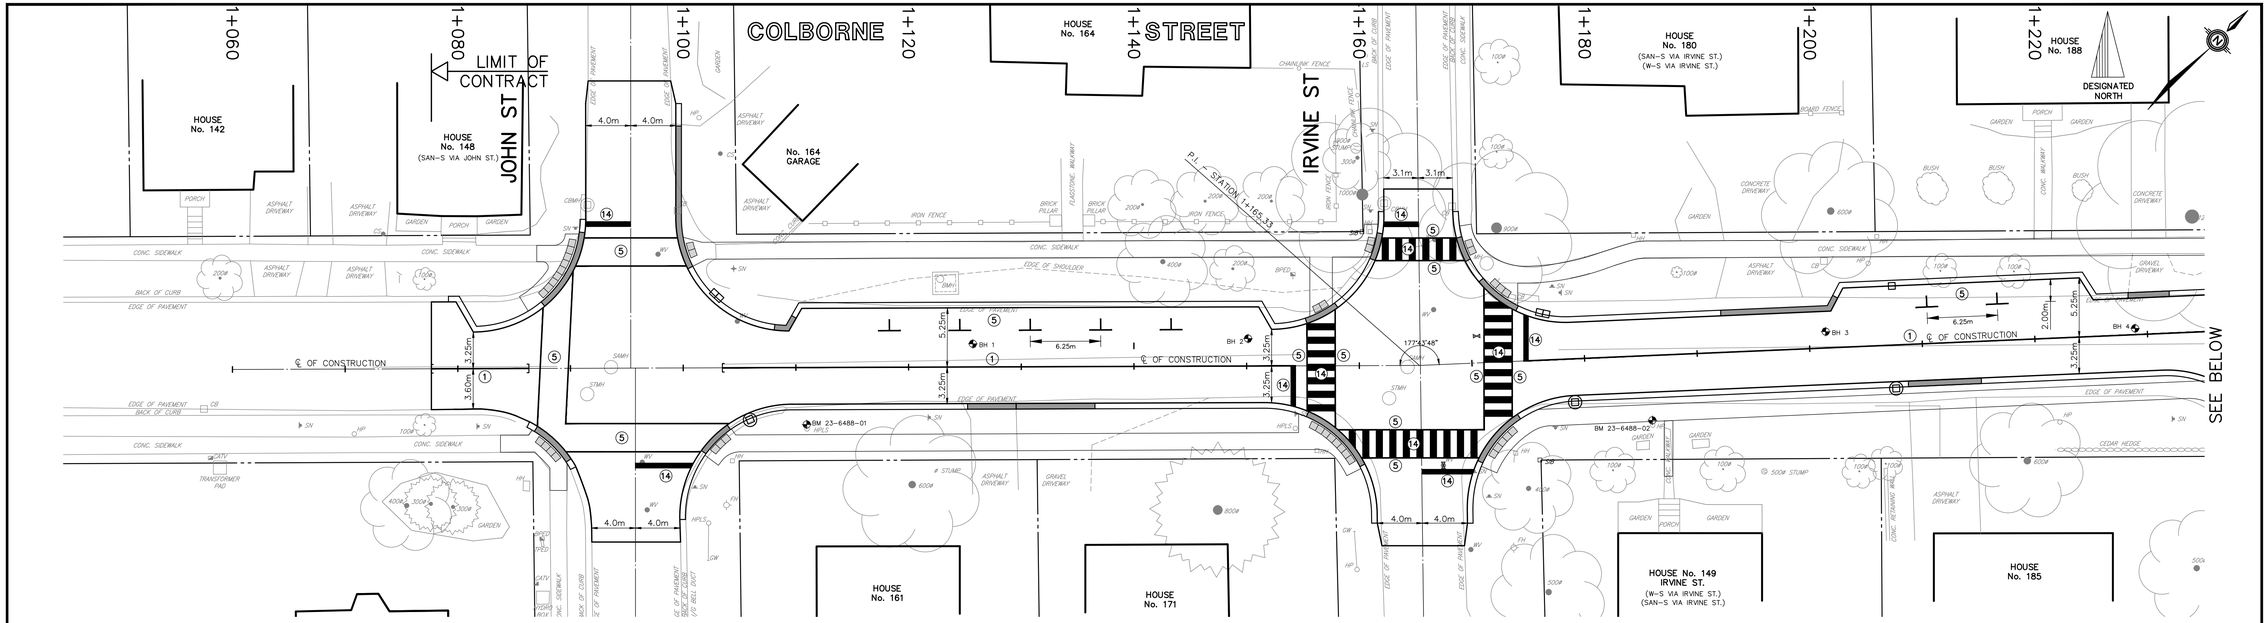

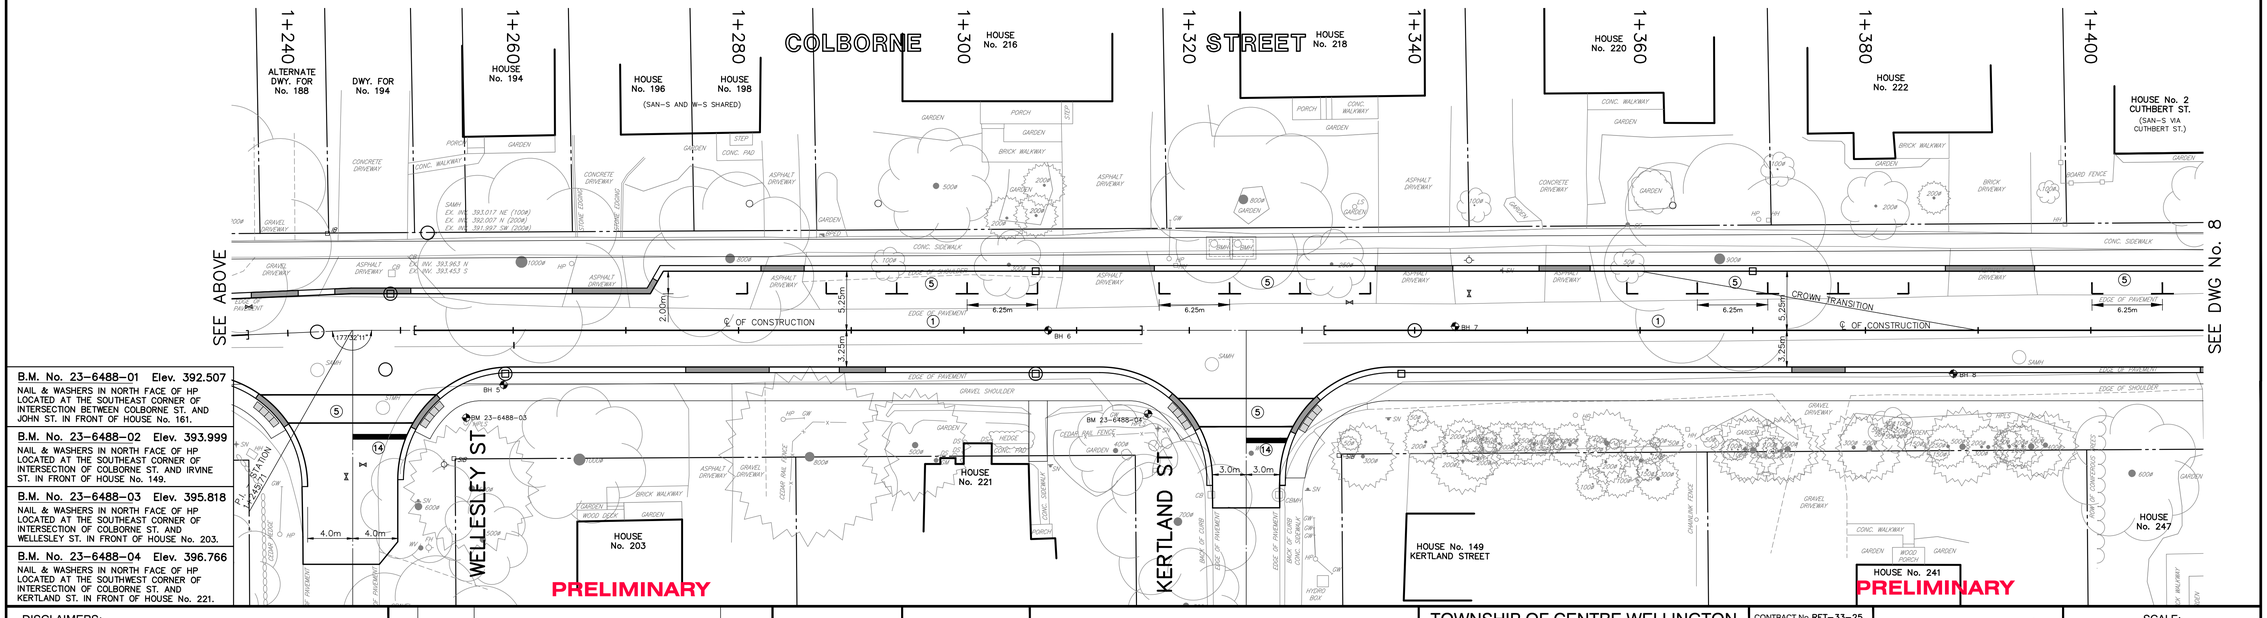

LEGEND – PAVEMENT MARKINGS

- 1 SOLID YELLOW, 10cm
- 5 SOLID WHITE, 10cm
- 14 SOLID WHITE, 45cm
-][LIMITS OF MARKINGS

NOTES:

1. USE ① TO DENOTE PAVEMENT MARKING
2. USE ① TO DENOTE PAVEMENT MARKING, DURABLE

B.M. No. 23–6488–01 Elev. 392.507
NAIL & WASHERS IN NORTH FACE OF HP LOCATED AT THE SOUTHEAST CORNER OF INTERSECTION BETWEEN COLBORNE ST. AND JOHN ST. IN FRONT OF HOUSE No. 161.

B.M. No. 23–6488–02 Elev. 393.999
NAIL & WASHERS IN NORTH FACE OF HP LOCATED AT THE SOUTHEAST CORNER OF INTERSECTION OF COLBORNE ST. AND IRVINE ST. IN FRONT OF HOUSE No. 149.

B.M. No. 23–6488–03 Elev. 395.818
NAIL & WASHERS IN NORTH FACE OF HP LOCATED AT THE SOUTHEAST CORNER OF INTERSECTION OF COLBORNE ST. AND WELLESLEY ST. IN FRONT OF HOUSE No. 203.

B.M. No. 23–6488–04 Elev. 396.766
NAIL & WASHERS IN NORTH FACE OF HP LOCATED AT THE SOUTHWEST CORNER OF INTERSECTION OF COLBORNE ST. AND KERTLAND ST. IN FRONT OF HOUSE No. 221.

DISCLAIMERS:

1. ALL EXISTING ELEVATIONS & DIMENSIONS TO BE CONFIRMED ON SITE. THE LOCATION OF UTILITIES IS APPROXIMATE ONLY AND SHOULD BE, DETERMINED BY CONSULTING THE MUNICIPAL AUTHORITIES AND UTILITY COMPANIES CONCERNED. THE CONTRACTOR SHALL PROVE THE LOCATION OF UTILITIES AND SHALL BE RESPONSIBLE FOR ADEQUATE PROTECTION AGAINST DAMAGE.

No	DATE	REVISION	INITIAL
2	MAY 2025	ISSUED FOR CONSTRUCTION	D.G.D.
1	MAR 2025	ISSUED FOR TENDER	D.G.D.

PRELIMINARY

RECONSTRUCTION OF
COLBORNE STREET
(ELORA)

TOWNSHIP OF CENTRE WELLINGTON
1 MACDONALD SQUARE
ELORA, ONTARIO N0B 1S0

PAVEMENT MARKING PLAN
1+050 TO 1+410

CONTRACT No.	RFT–33–25
PROJECT No.	M6488
DRAWN BY:	A.V.R.
CHECKED BY:	D.P.S.
APPROVED BY:	D.G.D.
DATE:	JANUARY 2025


TRITON ENGINEERING SERVICES LIMITED
Consulting Engineers

SCALE:
H: 1:250 H: 1:500
V: 1:50 V: 1:100
(24x36") (11x17")
UNLESS OTHERWISE SHOWN

DRAWING NUMBER **07**

r:\centre wellington\m6488 – colborne st (john–wilson)\ elora\cad and survey\m6488 – colborne st c3d.dwg – 2024–09–23 – dvanmooyen

ARCH full bleed D (36.00 x 24.00 Inches)

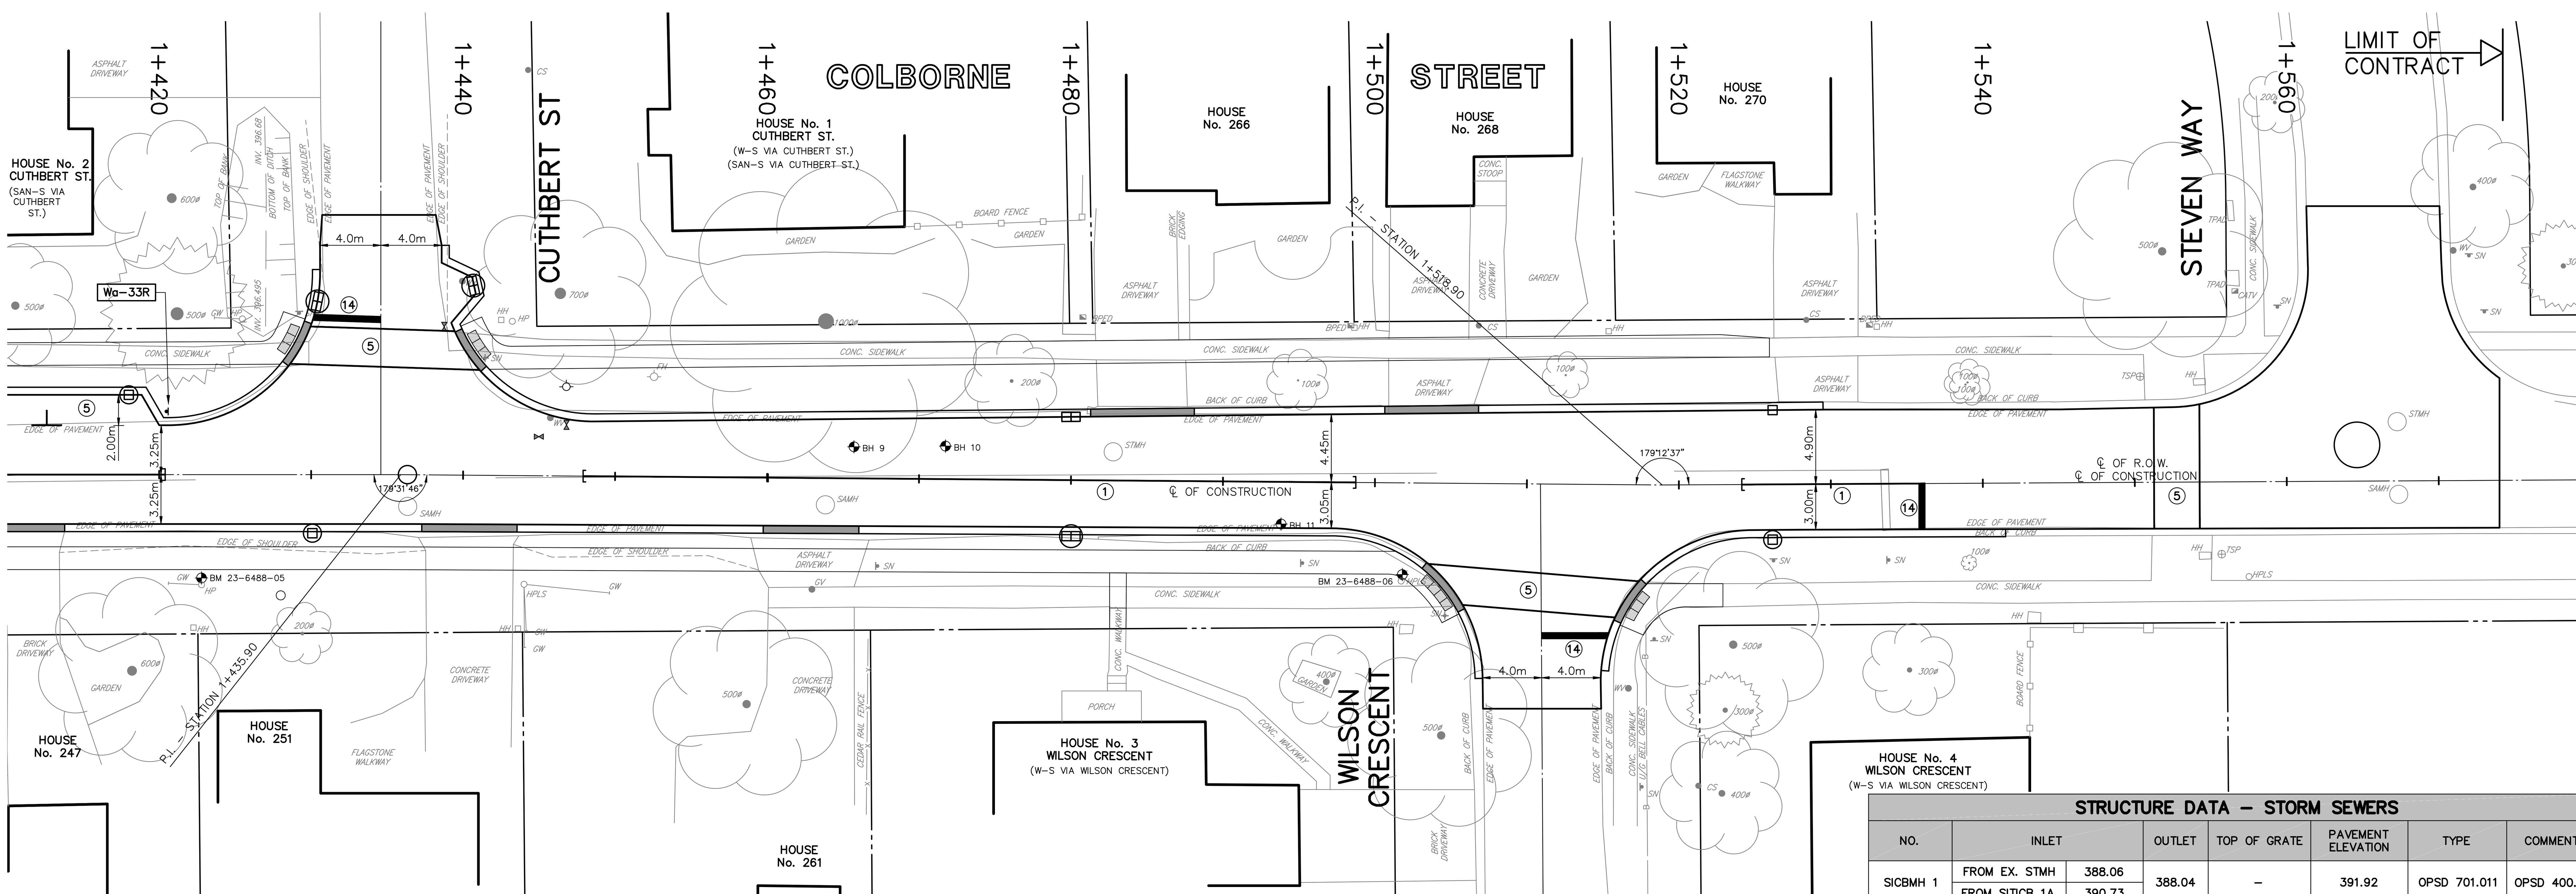


LEGEND – PAVEMENT MARKINGS

1	SOLID YELLOW, 10cm
5	SOLID WHITE, 10cm
14	SOLID WHITE, 45cm
][	LIMITS OF MARKINGS

NOTES:

1. USE ① TO DENOTE PAVEMENT MARKING
2. USE ① TO DENOTE PAVEMENT MARKING, DURABLE

SIGNS

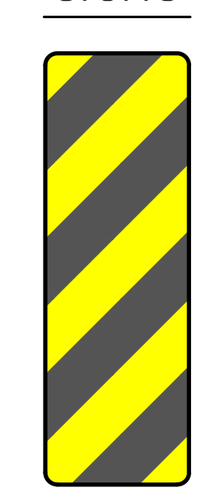

Wa-33R

STRUCTURE DATA – SANITARY SEWERS

NO.	INLET		OUTLET	TOP OF GRATE	PAVEMENT ELEVATION	TYPE	COMMENTS
SAMH 1	FROM SAMH 2	391.76	391.71	395.38	–	OPSD 701.010	OPSD 401.010
	FROM SAMH 3	391.74	391.71*				
SAMH 2	FROM NORTH	392.01	391.96	395.93	–	OPSD 701.010	OPSD 401.010
	FROM HSE. No. 194	393.02					
SAMH 3	FROM SAMH 4	392.68	392.66	396.82	–	OPSD 701.010	OPSD 401.010
SAMH 4	FROM NORTH		393.46	397.14	–	OPSD 701.010	OPSD 401.010
	FROM EAST	393.48					

*SAMH 1 – West invert to be 'blocked' by diversion benching to force flow south towards Wellesley Street. Top of benching EL. 391.81

STRUCTURE DATA – STORM SEWERS

NO.	INLET		OUTLET	TOP OF GRATE	PAVEMENT ELEVATION	TYPE	COMMENTS
SICBMH 1	FROM EX. STMH	388.06	388.04	–	391.92	OPSD 701.011	OPSD 400.082
	FROM SITICB 1A	390.73					
SITICB 1A	–	–	390.78	–	392.24	OPSD 705.020	OPSD 400.082
SICBMH 2	FROM SITICB 2A	392.1	391.18	–	393.58	OPSD 701.010	OPSD 400.082
	FROM SICBMH 3	391.20					
SITICB 2A	–	–	392.17	–	393.64	OPSD 705.020	OPSD 400.082
SICBMH 3	FROM CB 3A	392.9	391.80	–	394.34	OPSD 701.010	OPSD 400.082
	FROM STMH 4	391.82					
CB 3A	–	–	392.91	394.58	–	OPSD 705.010	OPSD 400.110
STMH 4	FROM CBMH 4A	393.8	392.70	395.41	–	OPSD 701.010	OPSD 401.010 (TYPE B)
	FROM SICBMH 5	394.00					
CBMH 4A	FROM NORTH	393.93	393.85	395.65	–	OPSD 701.010	OPSD 400.110
SICBMH 5	FROM SICBMH 6	394.31	394.29	–	395.73	OPSD 701.010	OPSD 400.082
ID 5A	–	–	395.27	396.47	–	–	–
ID 5B	–	–	395.23	396.43	–	–	–
SICBMH 6	FROM SICB 7	394.99	394.92	–	396.38	OPSD 701.010	OPSD 400.082
	FROM CB 6A	394.97					
CB 6A	–	–	395.02	396.64	–	OPSD 705.010	OPSD 400.110
SICB 7	–	–	395.28	–	396.71	OPSD 705.010	OPSD 400.082
CBMH 8A	FROM CB 8E	395.92	395.87	397.14	–	OPSD 701.010	OPSD 400.110
† SICBMH 8	FROM CBMH 8A	395.80	395.71	–	397.11	OPSD 701.010	OPSD 400.082
	FROM TICBMH 8B	395.76					
	FROM ID 8D	395.90					
† TICBMH 8B	FROM TICBMH 8C	395.86	395.83	396.89	–	OPSD 701.011	OPSD 400.110 (LOW PROFILE FRAME)
	FROM NORTHWEST	396.03					
† TICBMH 8C	FROM NORTH	396.48	395.91	396.90	–	OPSD 701.011	OPSD 400.110 (LOW PROFILE FRAME)
ID 8D	–	–	396.00	397.20	–	–	–
CB 8E	FROM ID 8F	396.17	396.16	397.12	–	OPSD 705.010	OPSD 400.110
ID 8F	–	–	396.20	397.20	–	–	–
SITICBMH 9	FROM TICB 9A	395.68	395.38	–	396.86	OPSD 701.011	OPSD 400.082
	FROM SICBMH 8	395.46					
TICB 9A	–	–	395.72	396.84	–	OPSD 705.020	OPSD 400.110
SICBMH 10	FROM SITICBMH 9	395.24	395.22	–	397.09	OPSD 701.010	OPSD 400.082
	FROM CB 10A	395.59					
~~CB 10A~~	~~–~~	~~–~~	~~395.64~~	~~397.05~~	~~–~~	~~OPSD 705.010~~	~~OPSD 400.110~~
† STMH 11	FROM SICBMH 10	395.11	395.02	397.36	–	OPSD 701.014	OPSD 401.010 (TYPE B)
	FROM NORTH	395.00					

NOTE: All storm structures to have 600mm sump with the exception of STMH 11 which is to be benched as per OPSD 701.021.

~~NOTE: All OPSD-400.082 shall be model 400.082Z2 as manufactured by East Jordan~~

† Prior to fabrication, the contractor shall verify existing top/bottom of the concrete encased Bell structure at Cuthbert Street and Steven Way.

B.M. No. 23-6488-05 Elev. 397.356
NAIL & WASHERS IN NORTH FACE OF HP LOCATED AT SOUTH SIDE OF COLBORNE ST. BETWEEN HOUSE No.'S 247 AND 251.

B.M. No. 23-6488-06 Elev. 397.198
NAIL & WASHERS IN NORTH FACE OF HP LOCATED AT THE SOUTHWEST CORNER OF INTERSECTION OF COLBORNE ST. AND WILSON CRESCENT IN FRONT OF HOUSE No. 3.

PRELIMINARY

PRELIMINARY

DISCLAIMERS:

1. ALL EXISTING ELEVATIONS & DIMENSIONS TO BE CONFIRMED ON SITE. THE LOCATION OF UTILITIES IS APPROXIMATE ONLY AND SHOULD BE, DETERMINED BY CONSULTING THE MUNICIPAL AUTHORITIES AND UTILITY COMPANIES CONCERNED. THE CONTRACTOR SHALL PROVE THE LOCATION OF UTILITIES AND SHALL BE RESPONSIBLE FOR ADEQUATE PROTECTION AGAINST DAMAGE.

No	DATE	REVISION	INITIAL
3	MAY 2025	ISSUED FOR CONSTRUCTION	D.G.D.
2	MAY 2025	REVISED STORM SEWER	D.G.D.
1	MAR 2025	ISSUED FOR TENDER	D.G.D.

PRELIMINARY

RECONSTRUCTION OF
COLBORNE STREET
(ELORA)

TOWNSHIP OF CENTRE WELLINGTON
1 MACDONALD SQUARE
ELORA, ONTARIO N0B 1S0

PAVEMENT MARKING PLAN
1+410 TO 1+580
AND STRUCTURE DATA CHART

CONTRACT No.	RFT-33-25
PROJECT No.	M6488
DRAWN BY:	A.V.R.
CHECKED BY:	D.P.S.
APPROVED BY:	D.G.D.
DATE:	JANUARY 2025

TRITON ENGINEERING SERVICES LIMITED
Consulting Engineers

SCALE:
H: 1:250 V: 1:50 (24"x36")
H: 1:500 V: 1:100 (11"x17")
UNLESS OTHERWISE SHOWN

DRAWING NUMBER 08

r:\centre wellington\m6488 – colborne st (john–wilson), elora\cad and survey\m6488 – colborne st c3d.dwg – 2024–09–23 – avanrooyen

ARCH full bleed D (36.00 x 24.00 Inches)